


NOTES

- DATUMS:
HORIZONTAL- BASED UPON COMPASS OBSERVATION TAKEN ON 4/22/98.
ASSUMED COORDINATES
VERTICAL-BASED UPON MANHOLE #277 AS SHOWN ON PLAN REFERENCE #1 INV. OF MANHOLE 145.00
- RECORD DRAWING INFORMATION PROVIDED BY CHASE EXCAVATING INC.
- ALL SERVICES ARE APPROXIMATELY 7'-8" DEEP & HAVE A METAL TAB AT THE END WHICH CAN BE LOCATED WITH A METAL DETECTOR.

LEGEND

EDGE OF PAVEMENT	---
EXISTING CONTOUR	---o---
FENCE	---o---
WATER MAIN	---o---
HYDRANT	---o---
UTILITY POLE	---o---
STREET/YARD LIGHT	---o---
TREE	---o---
SHRUBS	---o---
MAILBOX	---o---

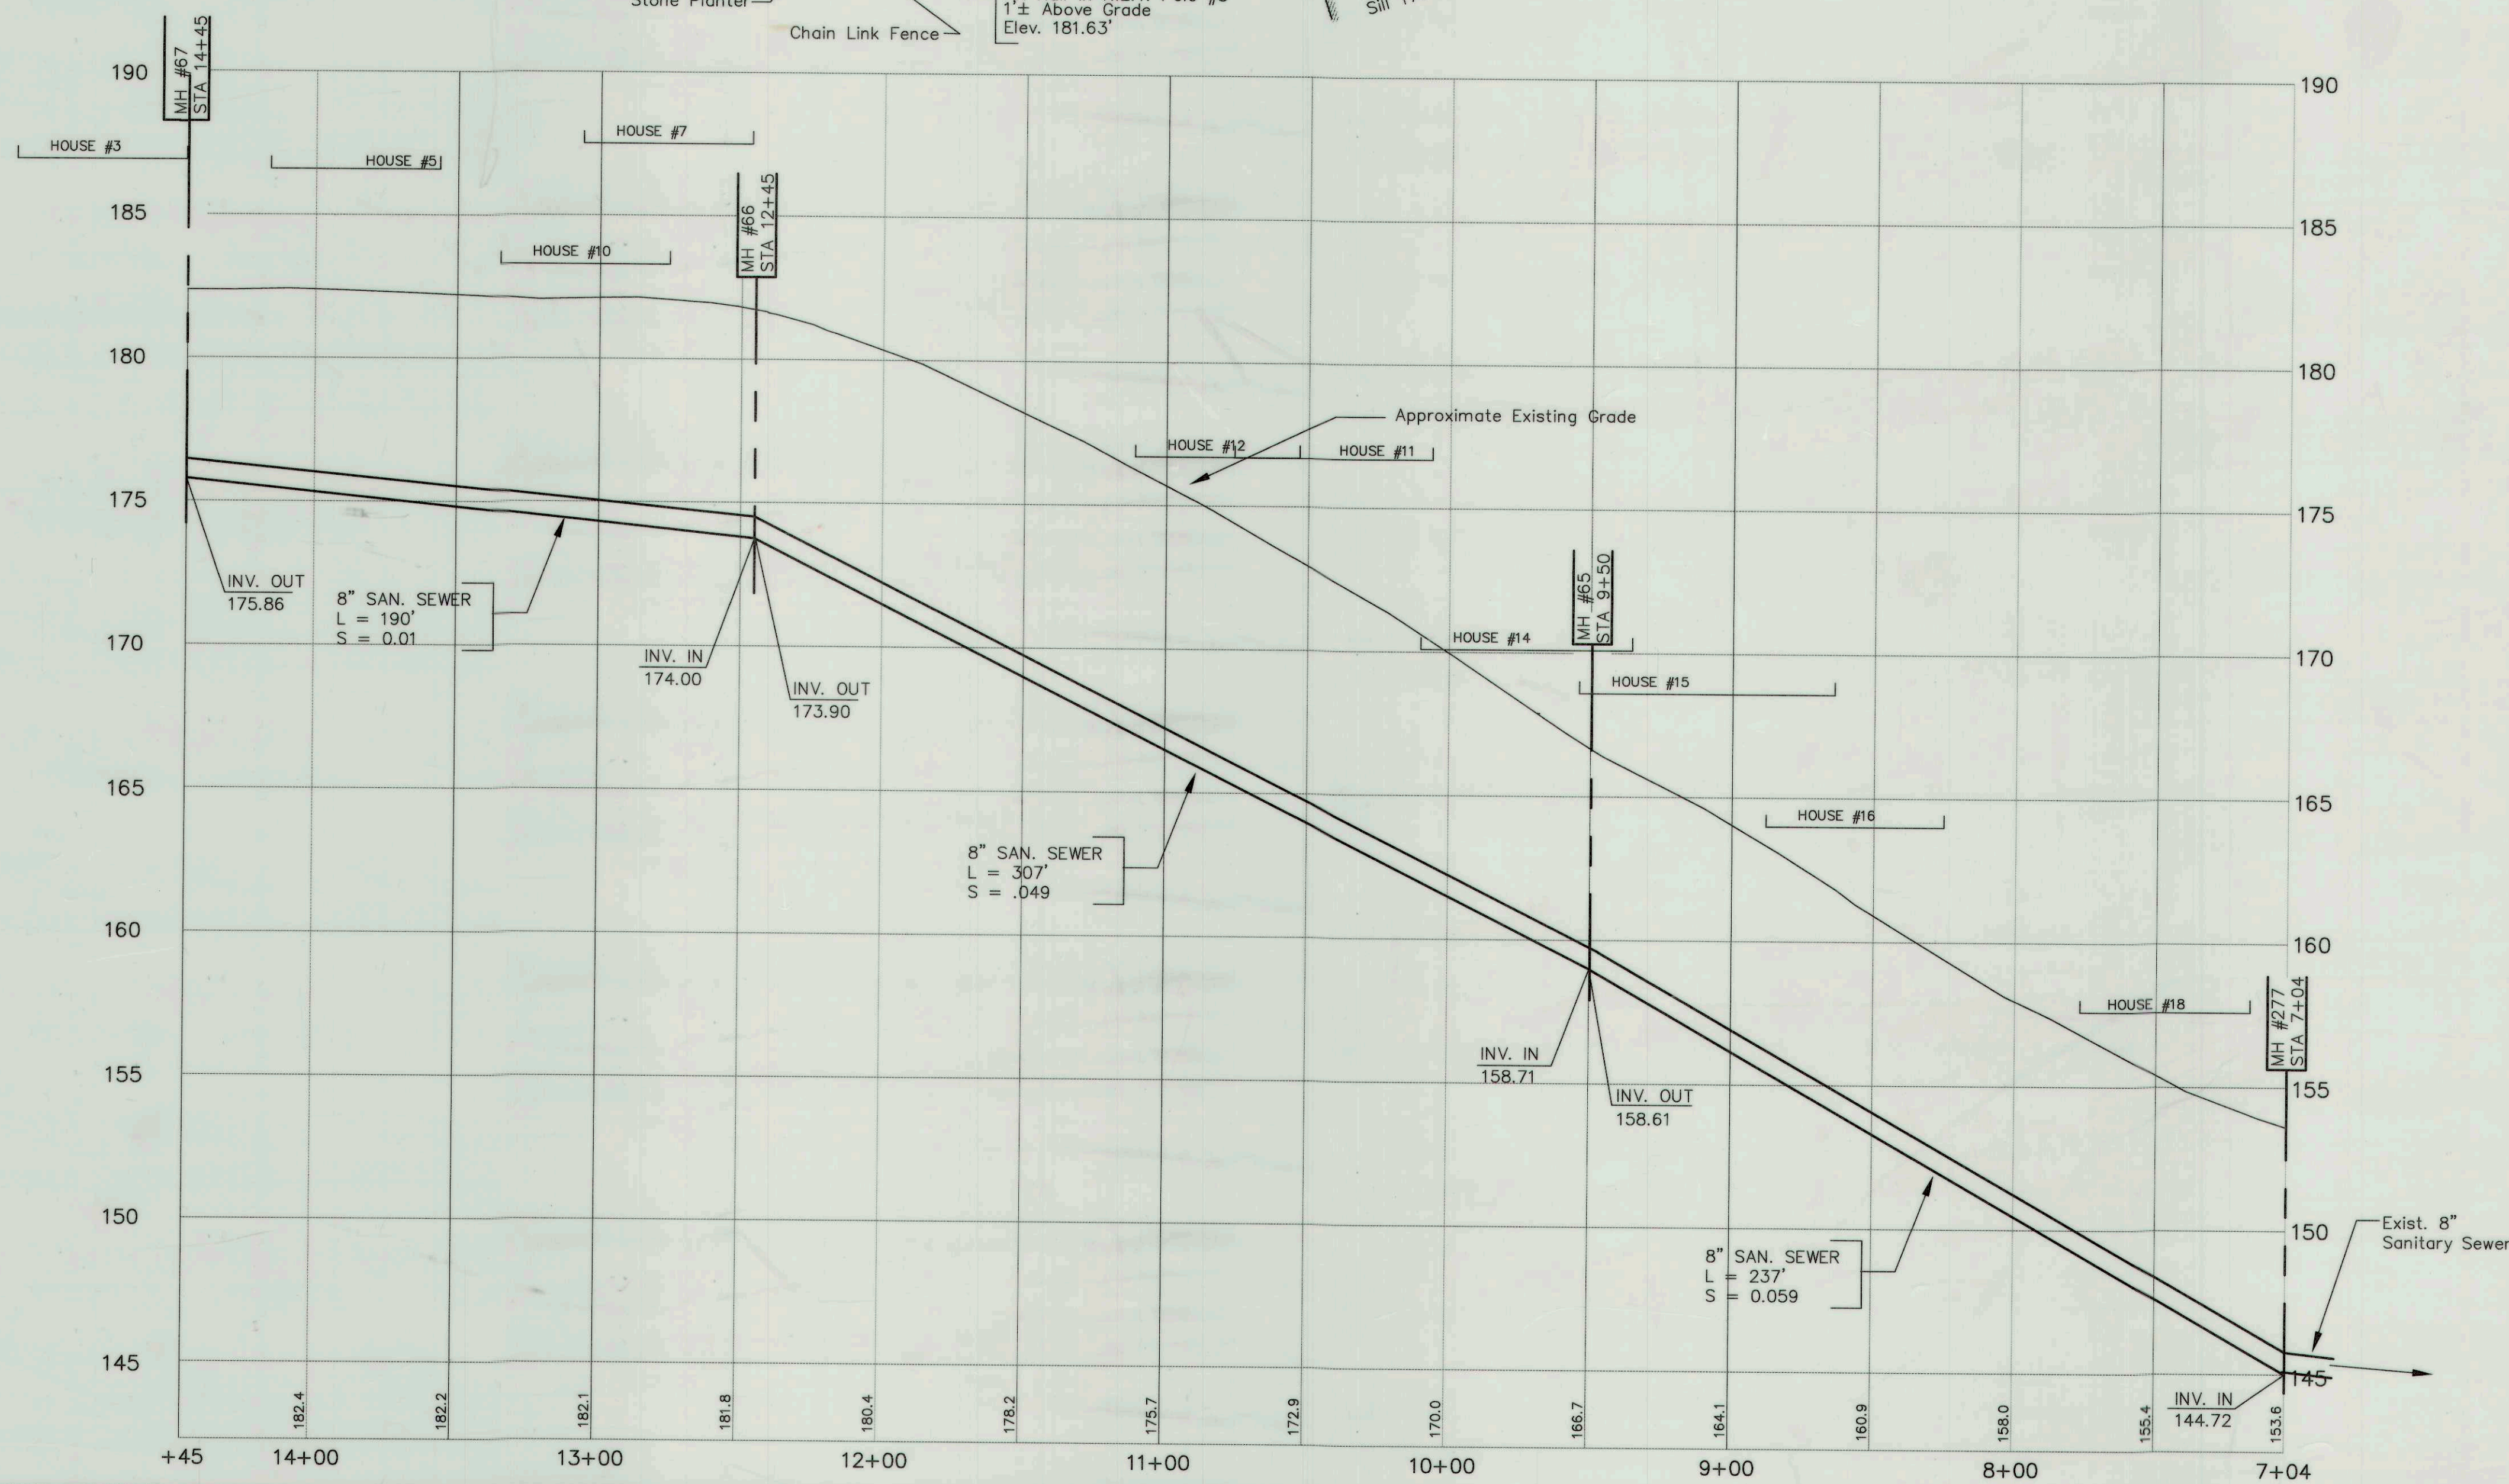

SQUAW BAY CORP.
Consulting Engineers




P.O. BOX 86A, CUMBERLAND CENTER, ME. 04021

CLIENT:





TOWN OF CUMBERLAND
P. O. BOX 128, CUMBERLAND, MAINE

FIELD BOOK # 980	DESIGN: JRK	PROJECT: SEWER EXTENSION CRESTWOOD ROAD, CUMBERLAND MAINE
FIELD BOOK PAGE	DRAWN: RWH	
FLAT FILE INDEX NUMBER	CHKD: JRK	
PROJECT DIR. 98-20001	DATE: MAY, 1998	PROJ. NO. 98-200-01
DRAWING NAME 9820001	SCALE: 1" = 40' HOR 1" = 4' VERT	DWG. NO. C-201
		REV. B

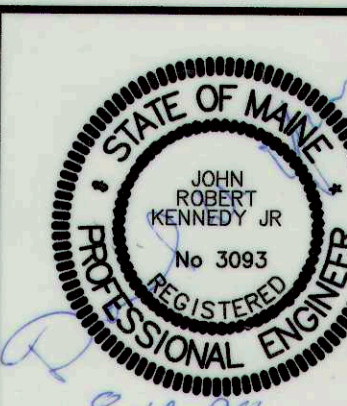

PLAN ENTITLED COLLECTOR SEWER SYSTEM-CONTRACT #4, BY E.C. JORDAN DATED 2/84
SHEET #C-222/227

NO.	REFERENCE DRAWINGS	REV.	DATE	STATUS	BY	CHKD	APPD
		B	8/13/98	RECORD DRAWINGS	SMT	DWY	DWY
		A	5/5/98	ISSUED FOR BIDS	RWH	JRK	JRK

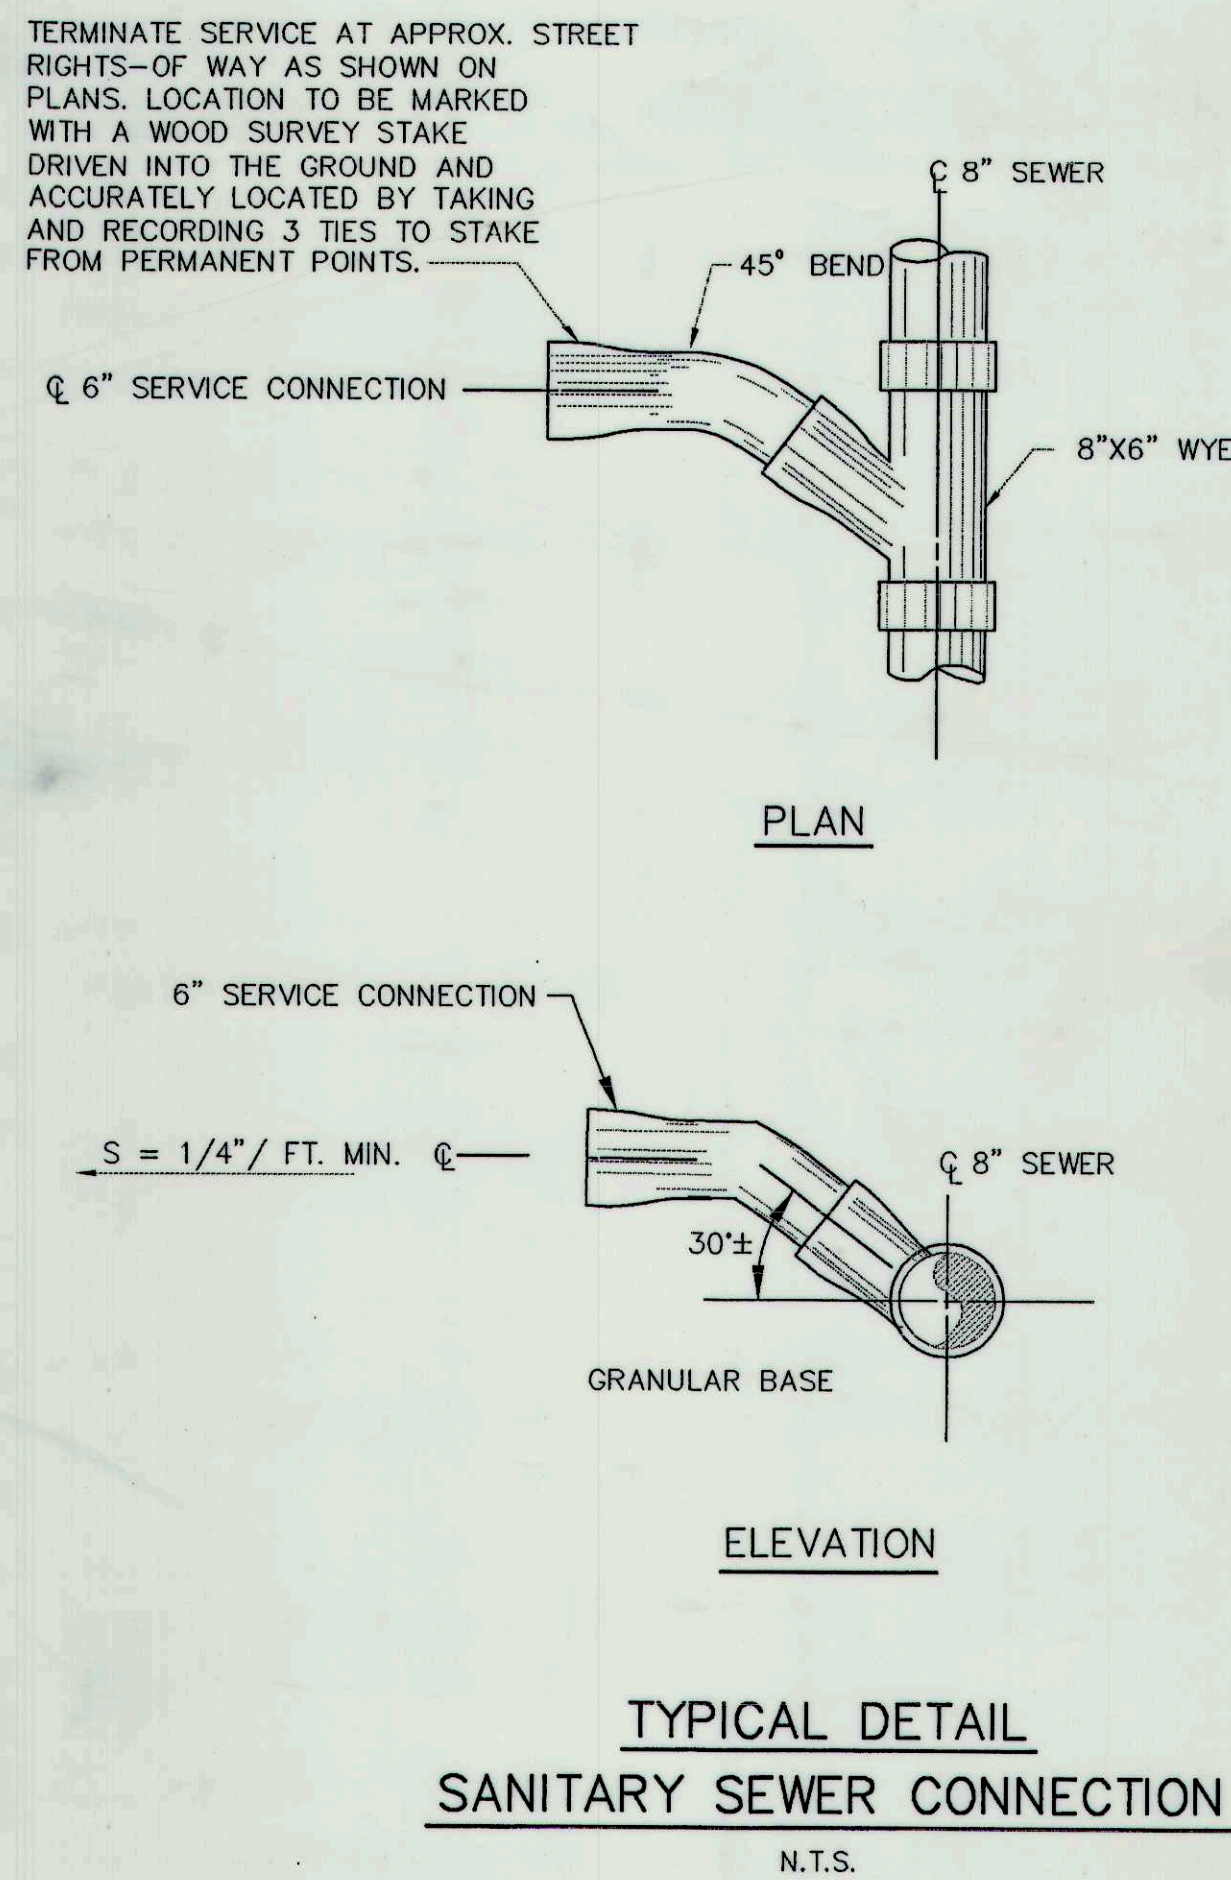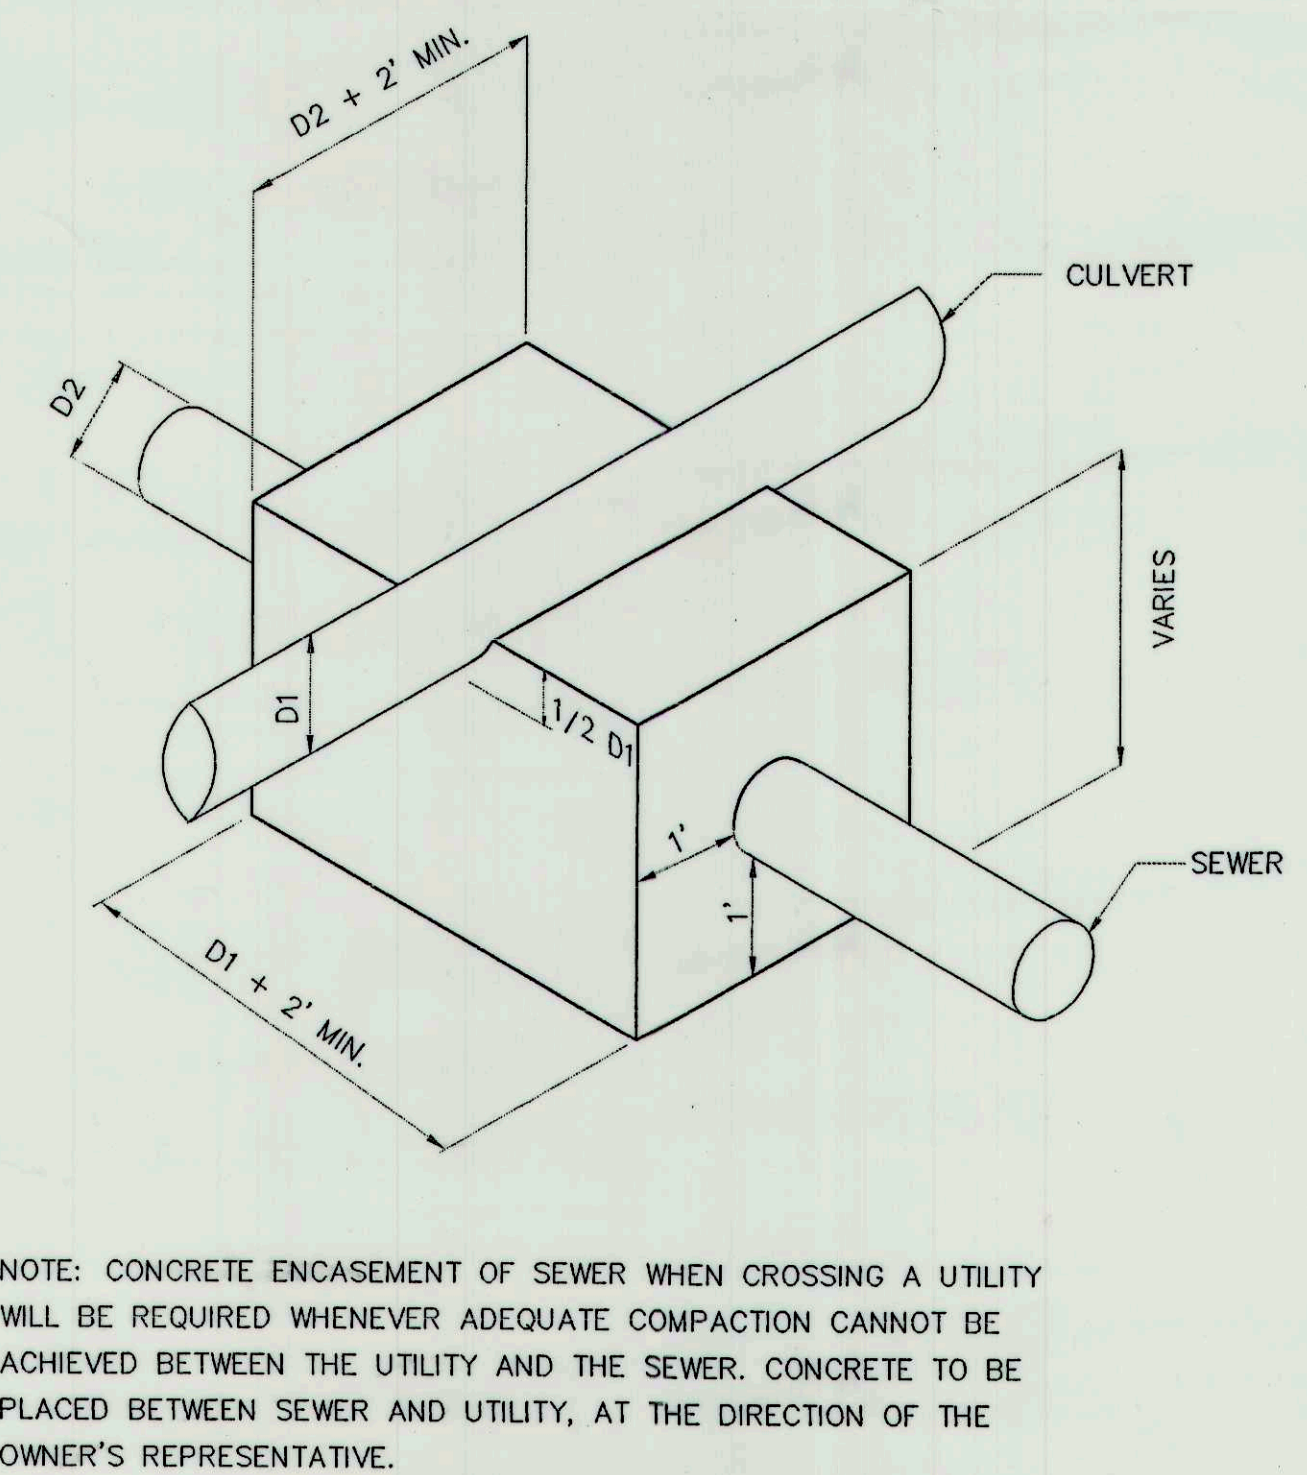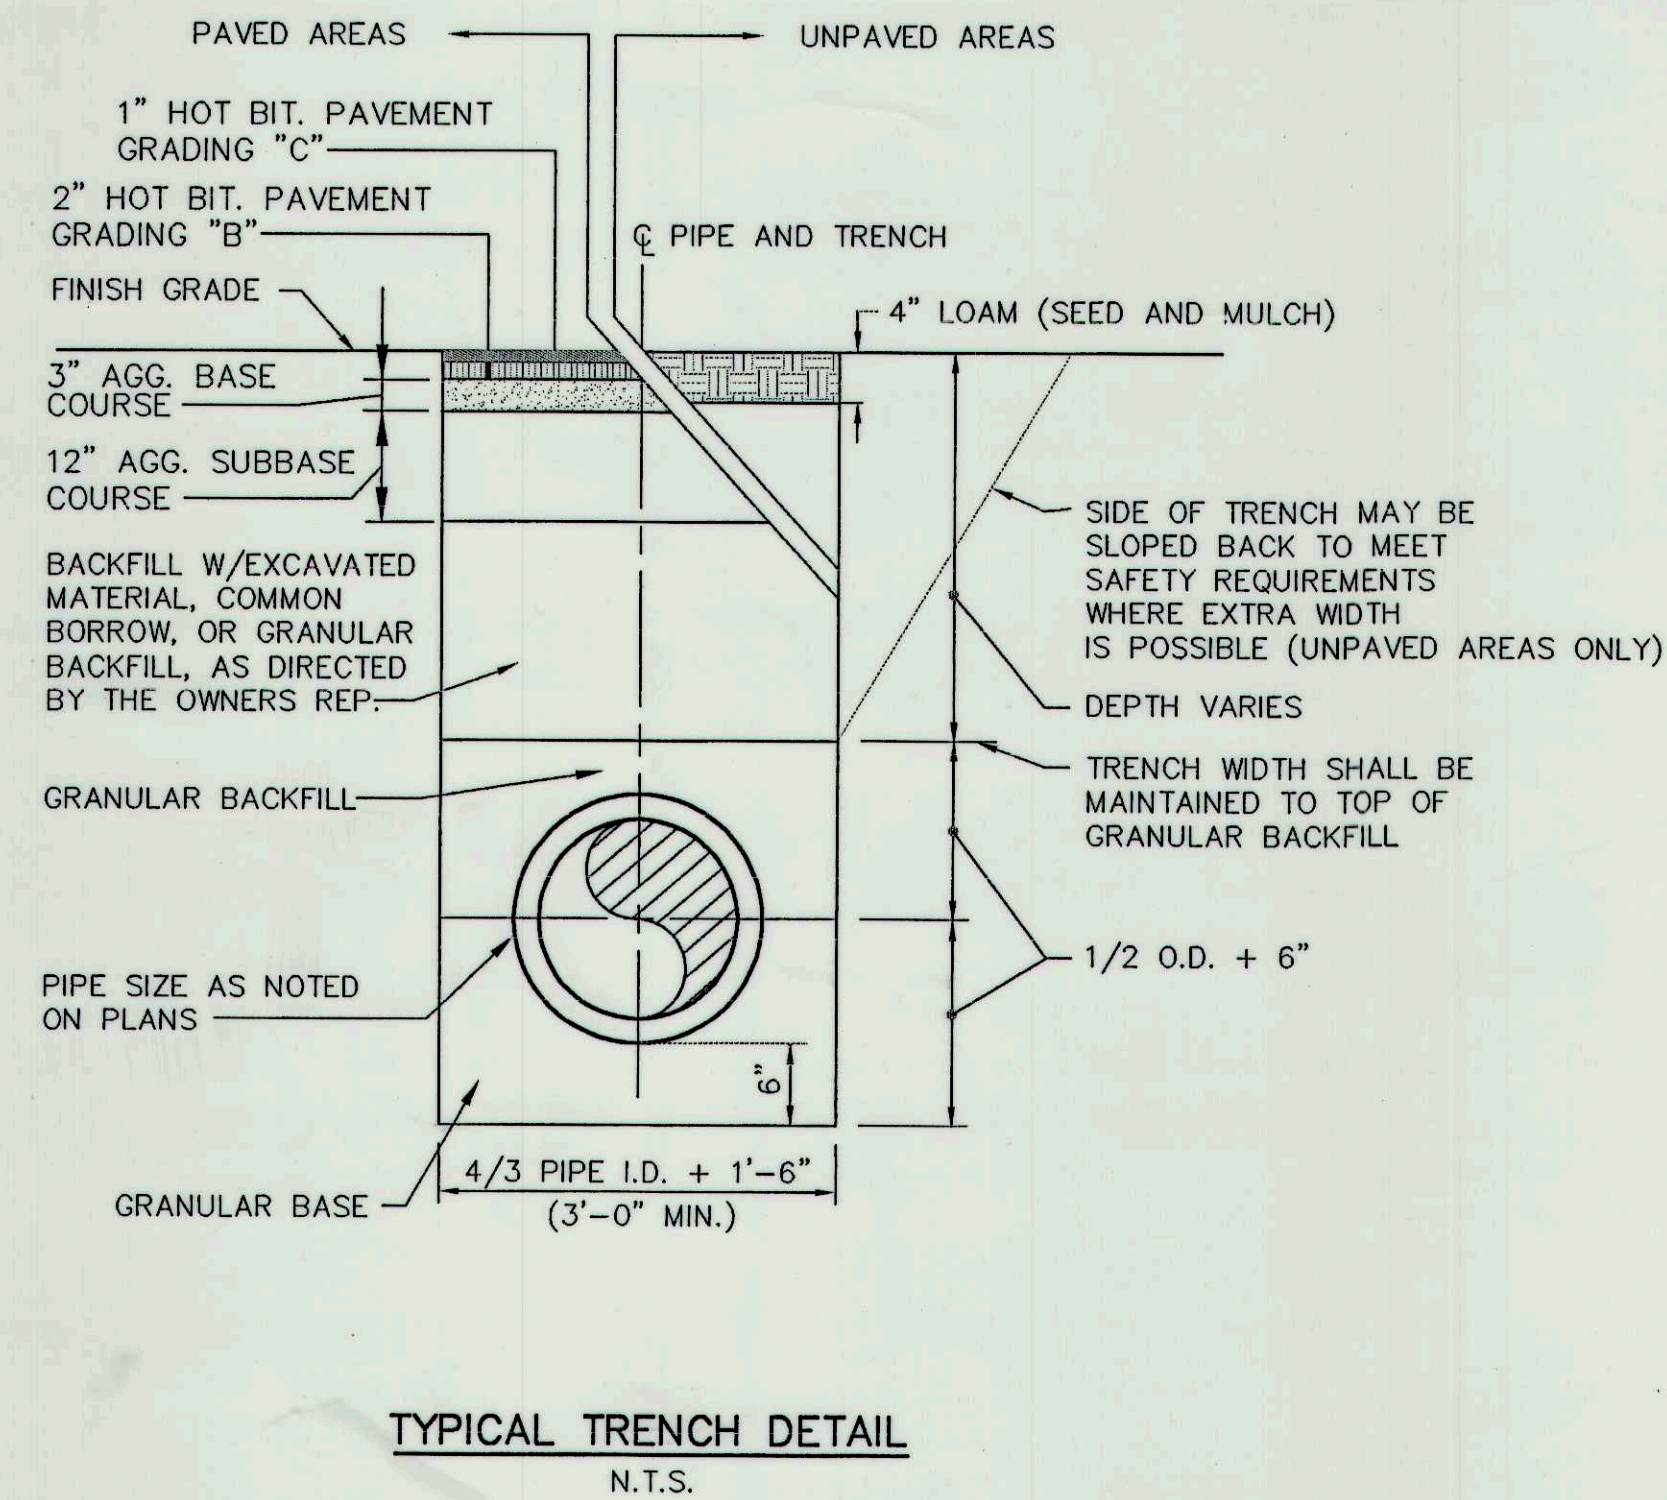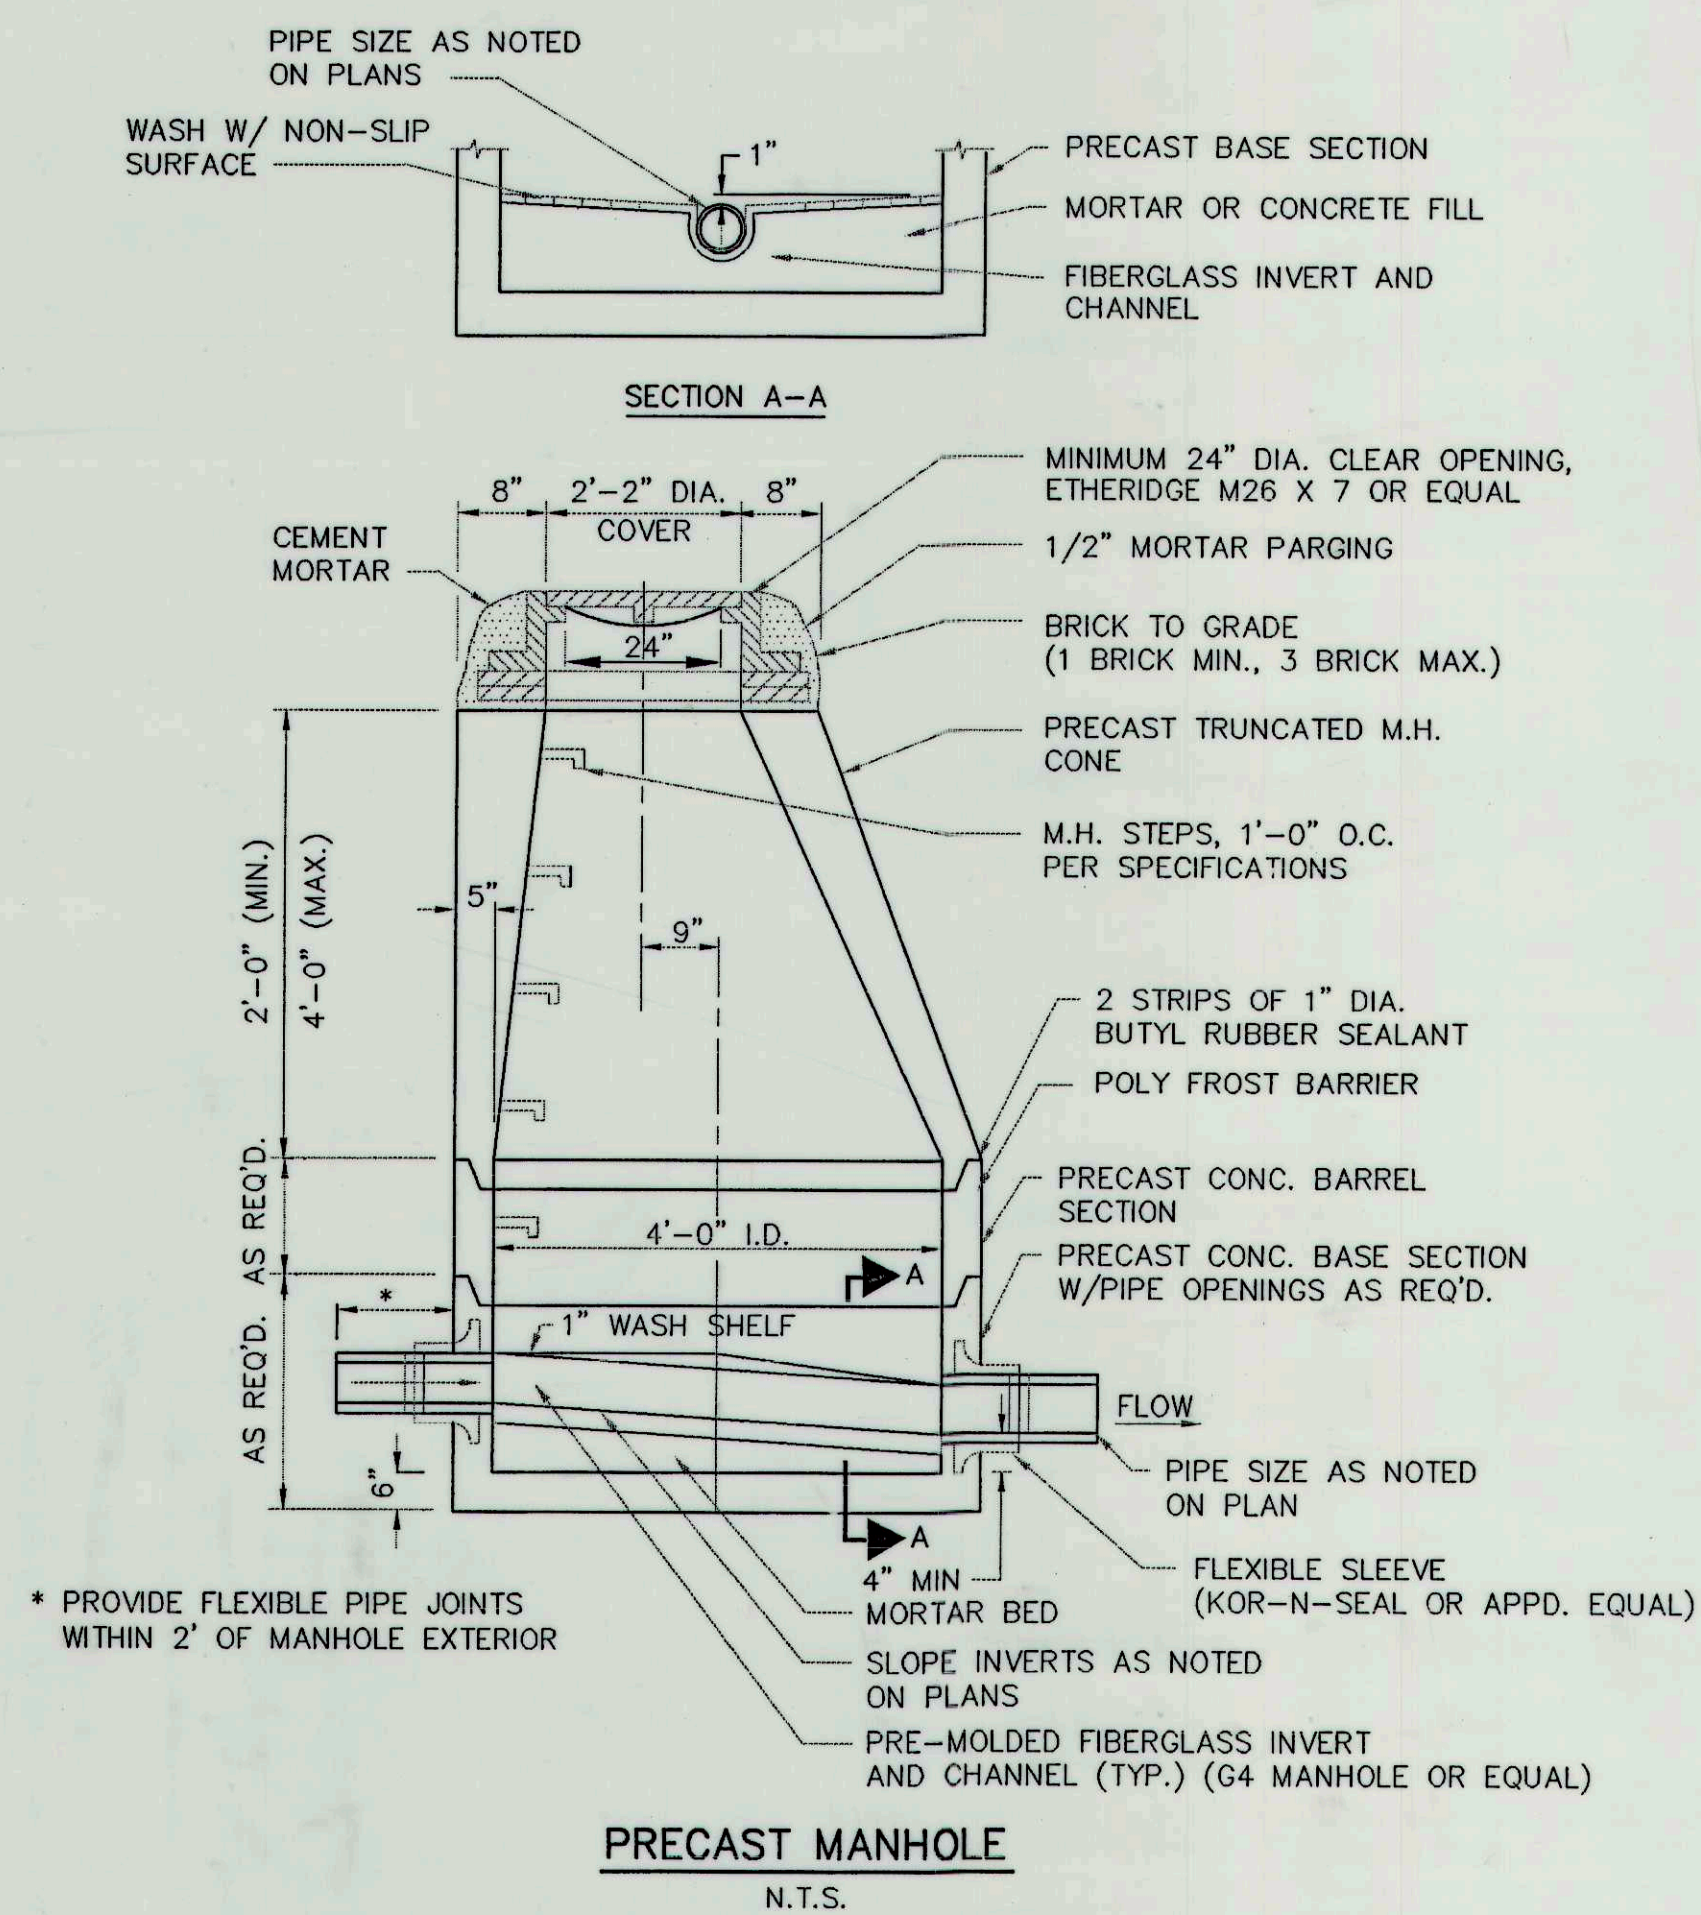

--	--	